



F H WA REGION NO	STATE	FED. AID PROJ. NO	SHEET NO.	TOTAL SHEETS
3	MD.			

EXISTING 12" SIGNALS	PROPOSED SIGNAL & SIGN	EXISTING SIGNS
1,2,5,6	9,11	13,14
3,4,7,8,10,12	15,16	
9,11		

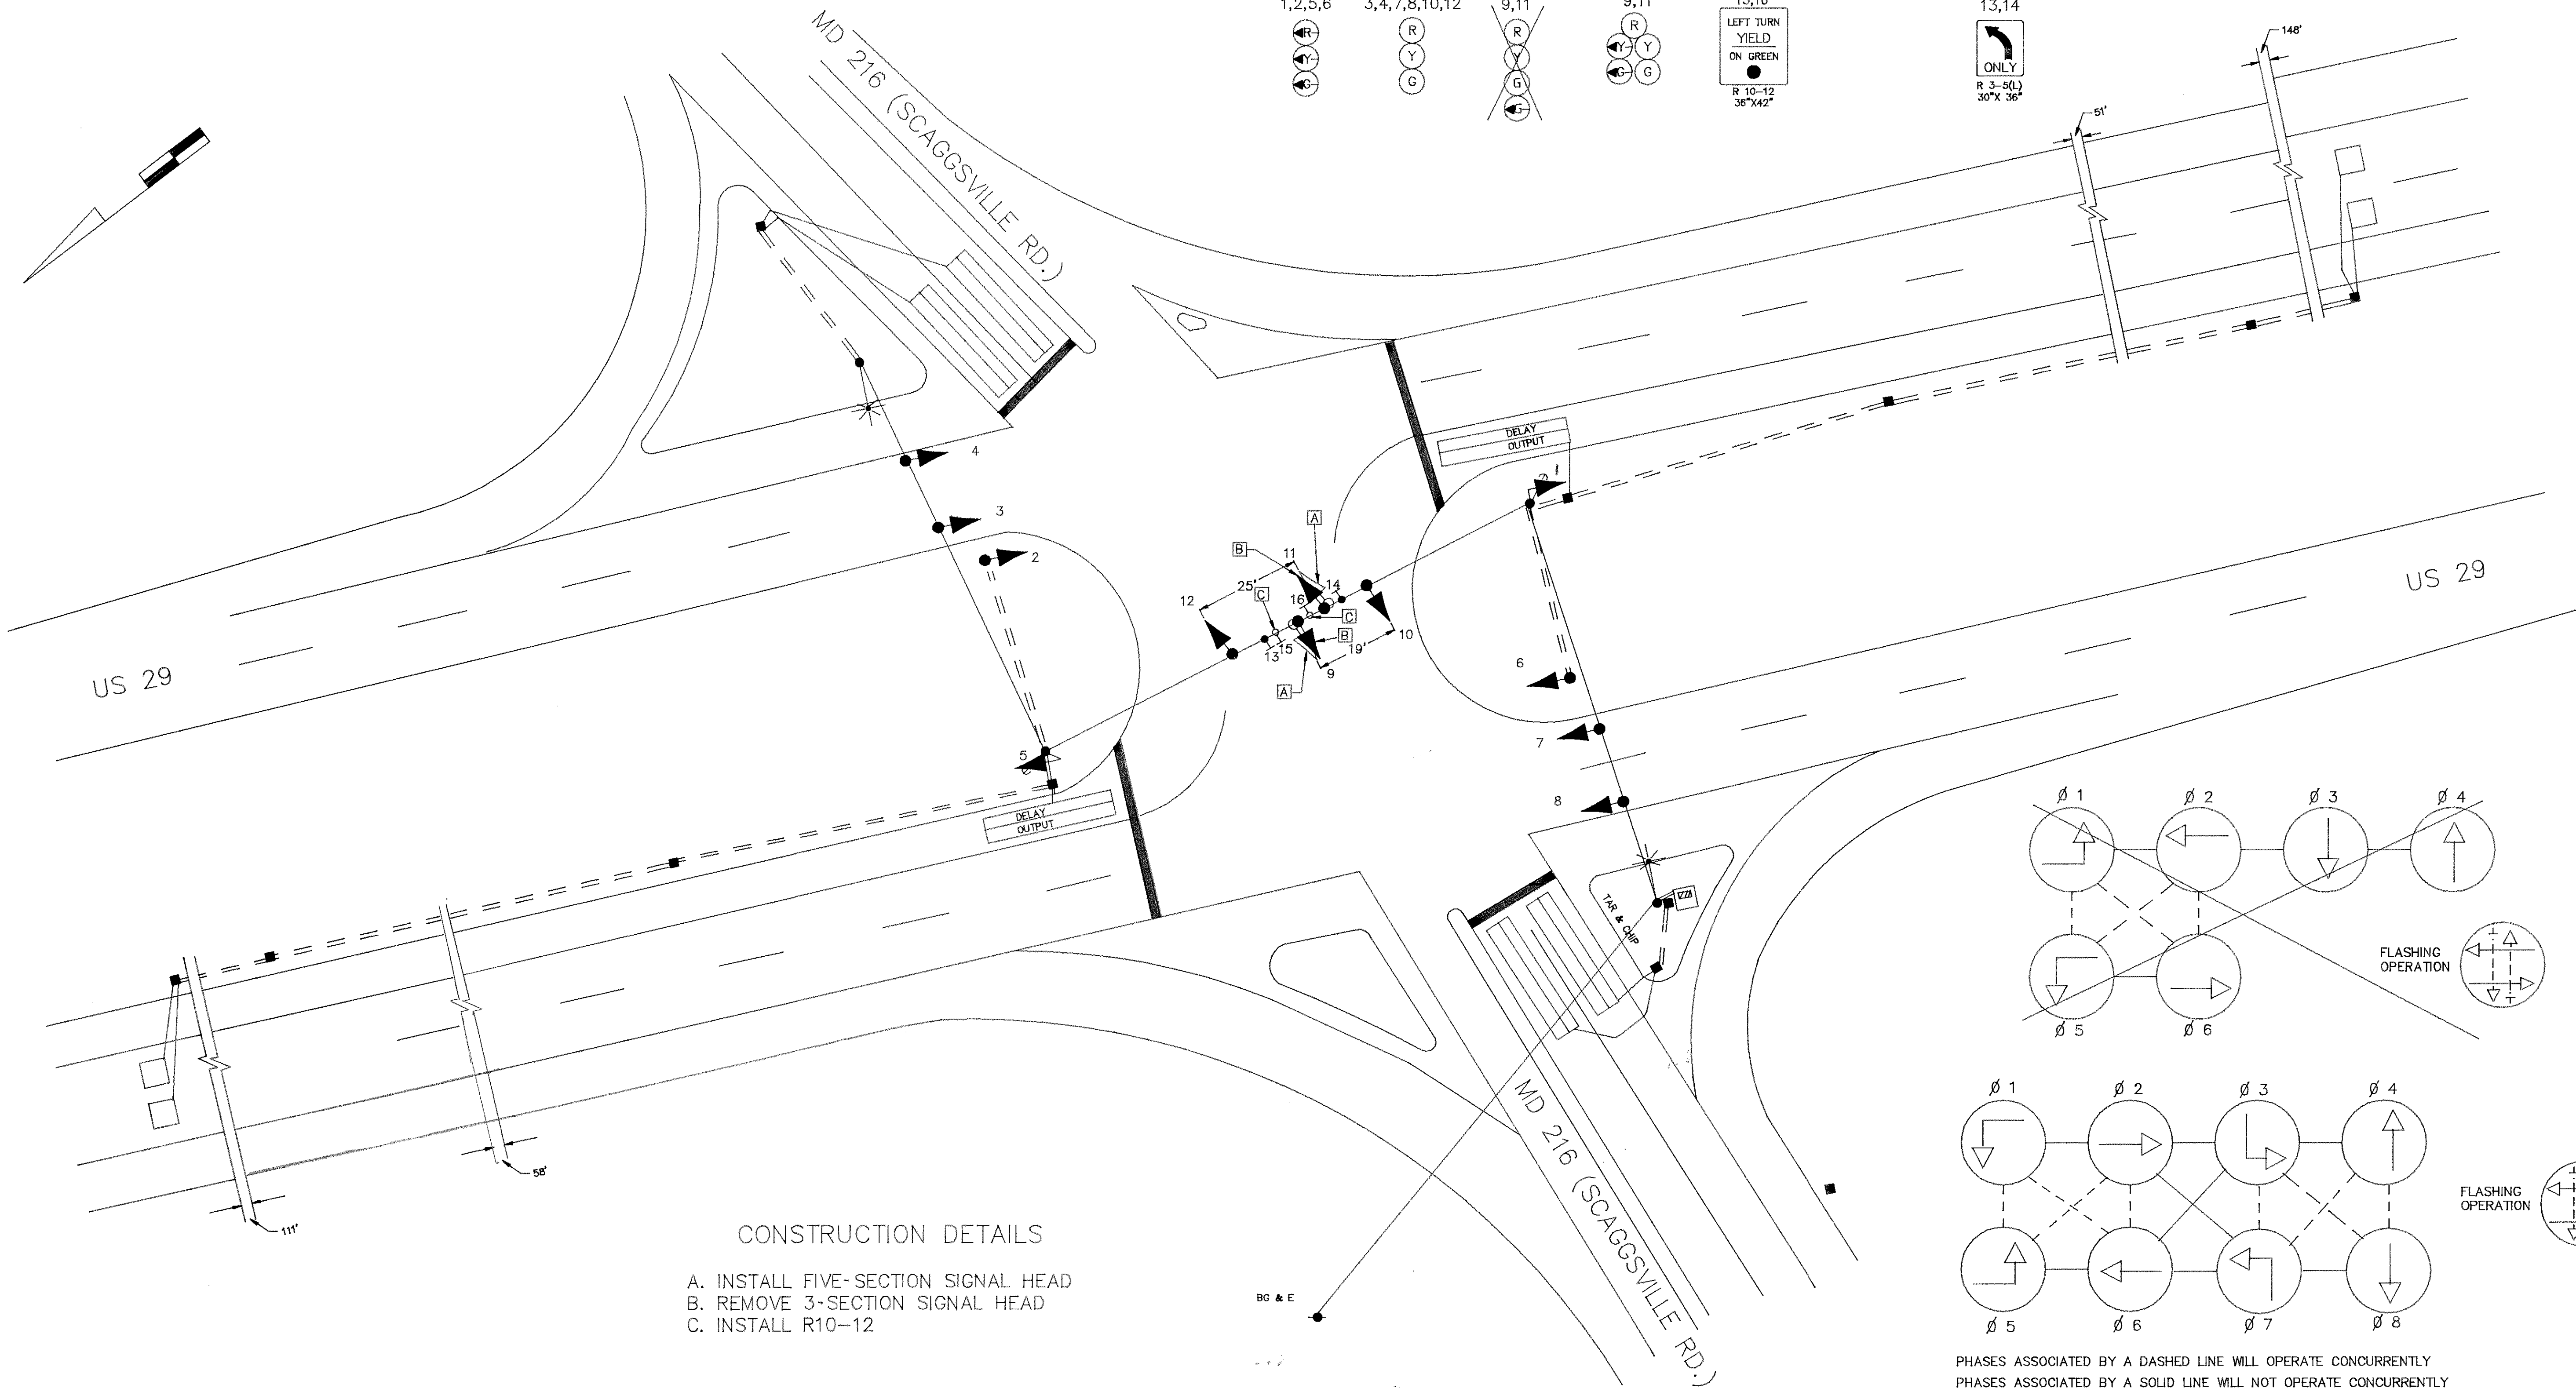

CONSTRUCTION DETAILS

- A. INSTALL FIVE-SECTION SIGNAL HEAD
- B. REMOVE 3-SECTION SIGNAL HEAD
- C. INSTALL R10-12

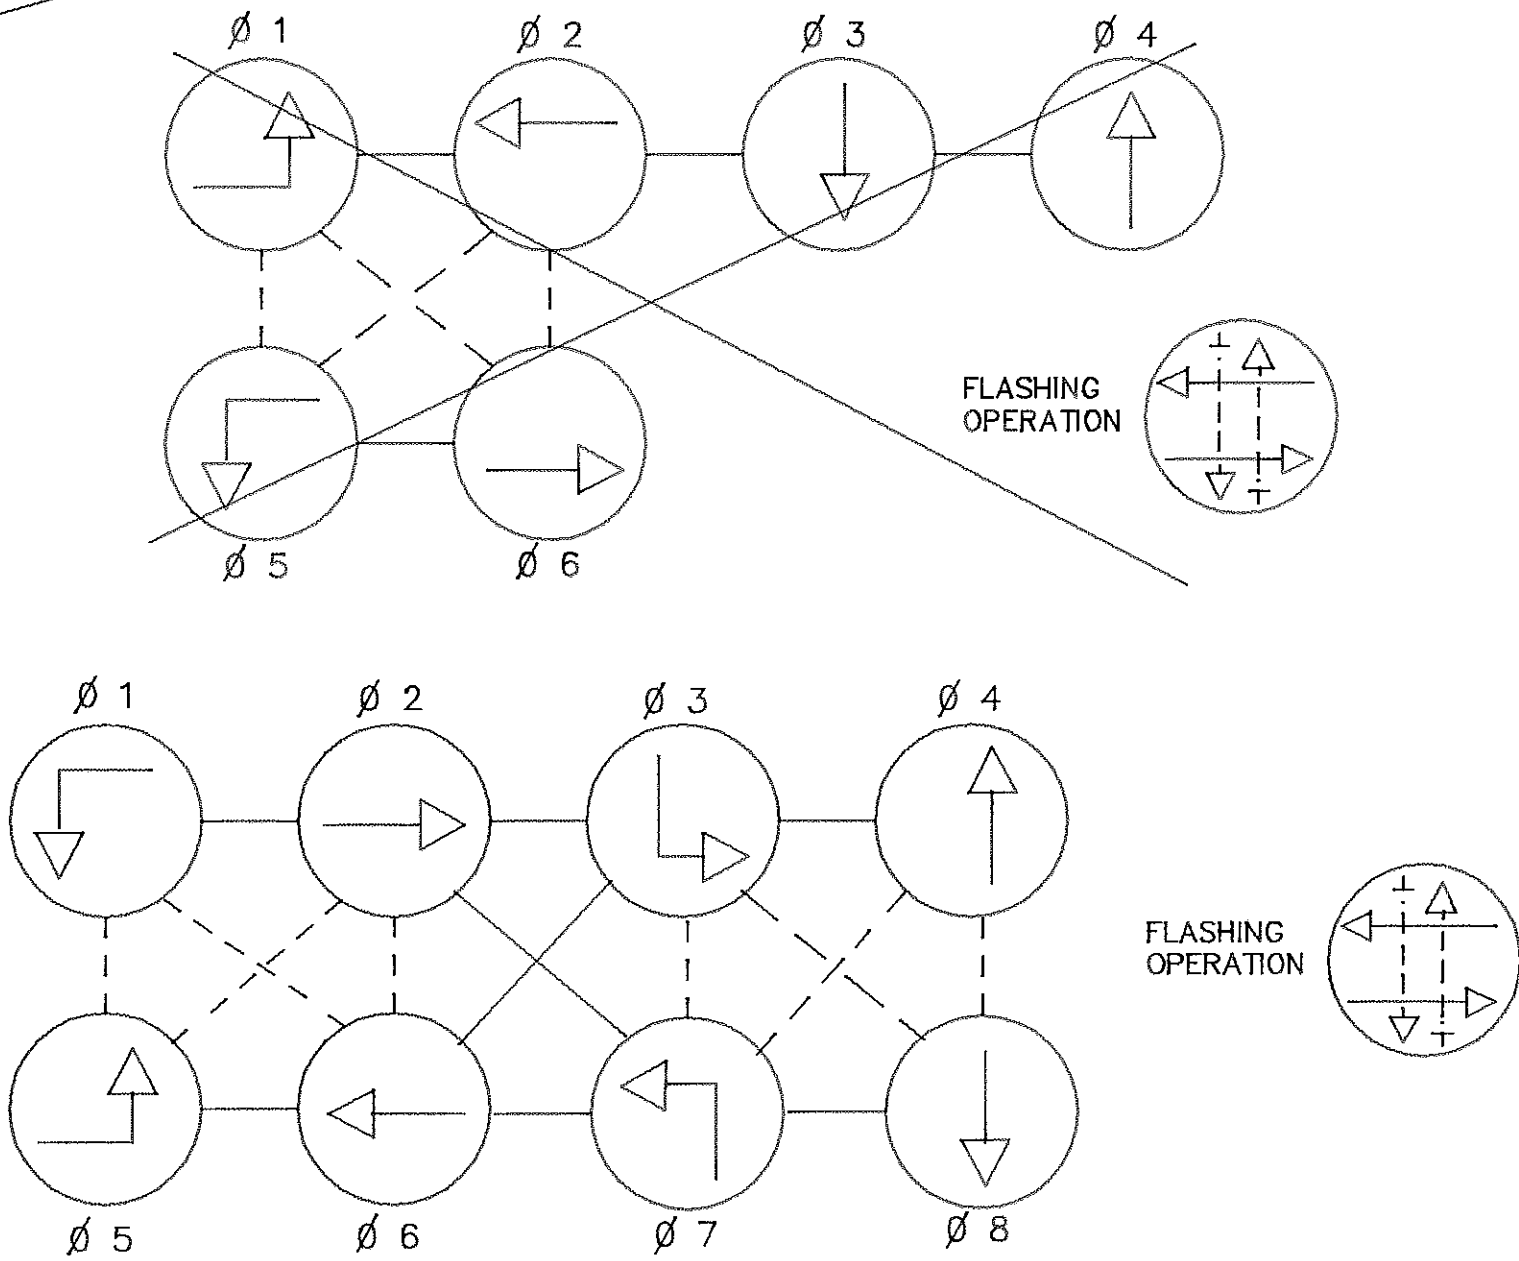

PHASES ASSOCIATED BY A DASHED LINE WILL OPERATE CONCURRENTLY  
 PHASES ASSOCIATED BY A SOLID LINE WILL NOT OPERATE CONCURRENTLY

REVISIONS ASBUILT 11/89 11/89 INSTALLED E/P L/T SIDE STREETS 4/99 SPLIT SIDE ROAD PHASING AND RE-CUT LOOPS B ASBUILT 8-14-74 RVC NEW CONTRACT HO-411X-775 11-18-70 HR		APPROVALS CHIEF, SIGNAL DESIGN SECTION ASST. DISTRICT ENGINEER, TRAFFIC CHIEF, TRAFFIC ENGINEERING DIVISION DEPUTY CHIEF ENGINEER, OFFICE OF TRAFFIC		MDOT - STATE HIGHWAY ADMINISTRATION Office of Traffic TRAFFIC ENGINEERING DIVISION SIGNAL # US 29 @ MD 216 COUNTY: HOWARD	
DRAWN BY: C. ALSTON\B. THOMPSON DES. BY: CHK. BY:		DATE: REDRAWN 11/88 SCALE:		F.A.P. NO. S.H.A. NO.	
TS/STD. NO. 127 D		SHEET NO. OF		13008901.38	